
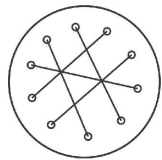


AVAILABLE #300

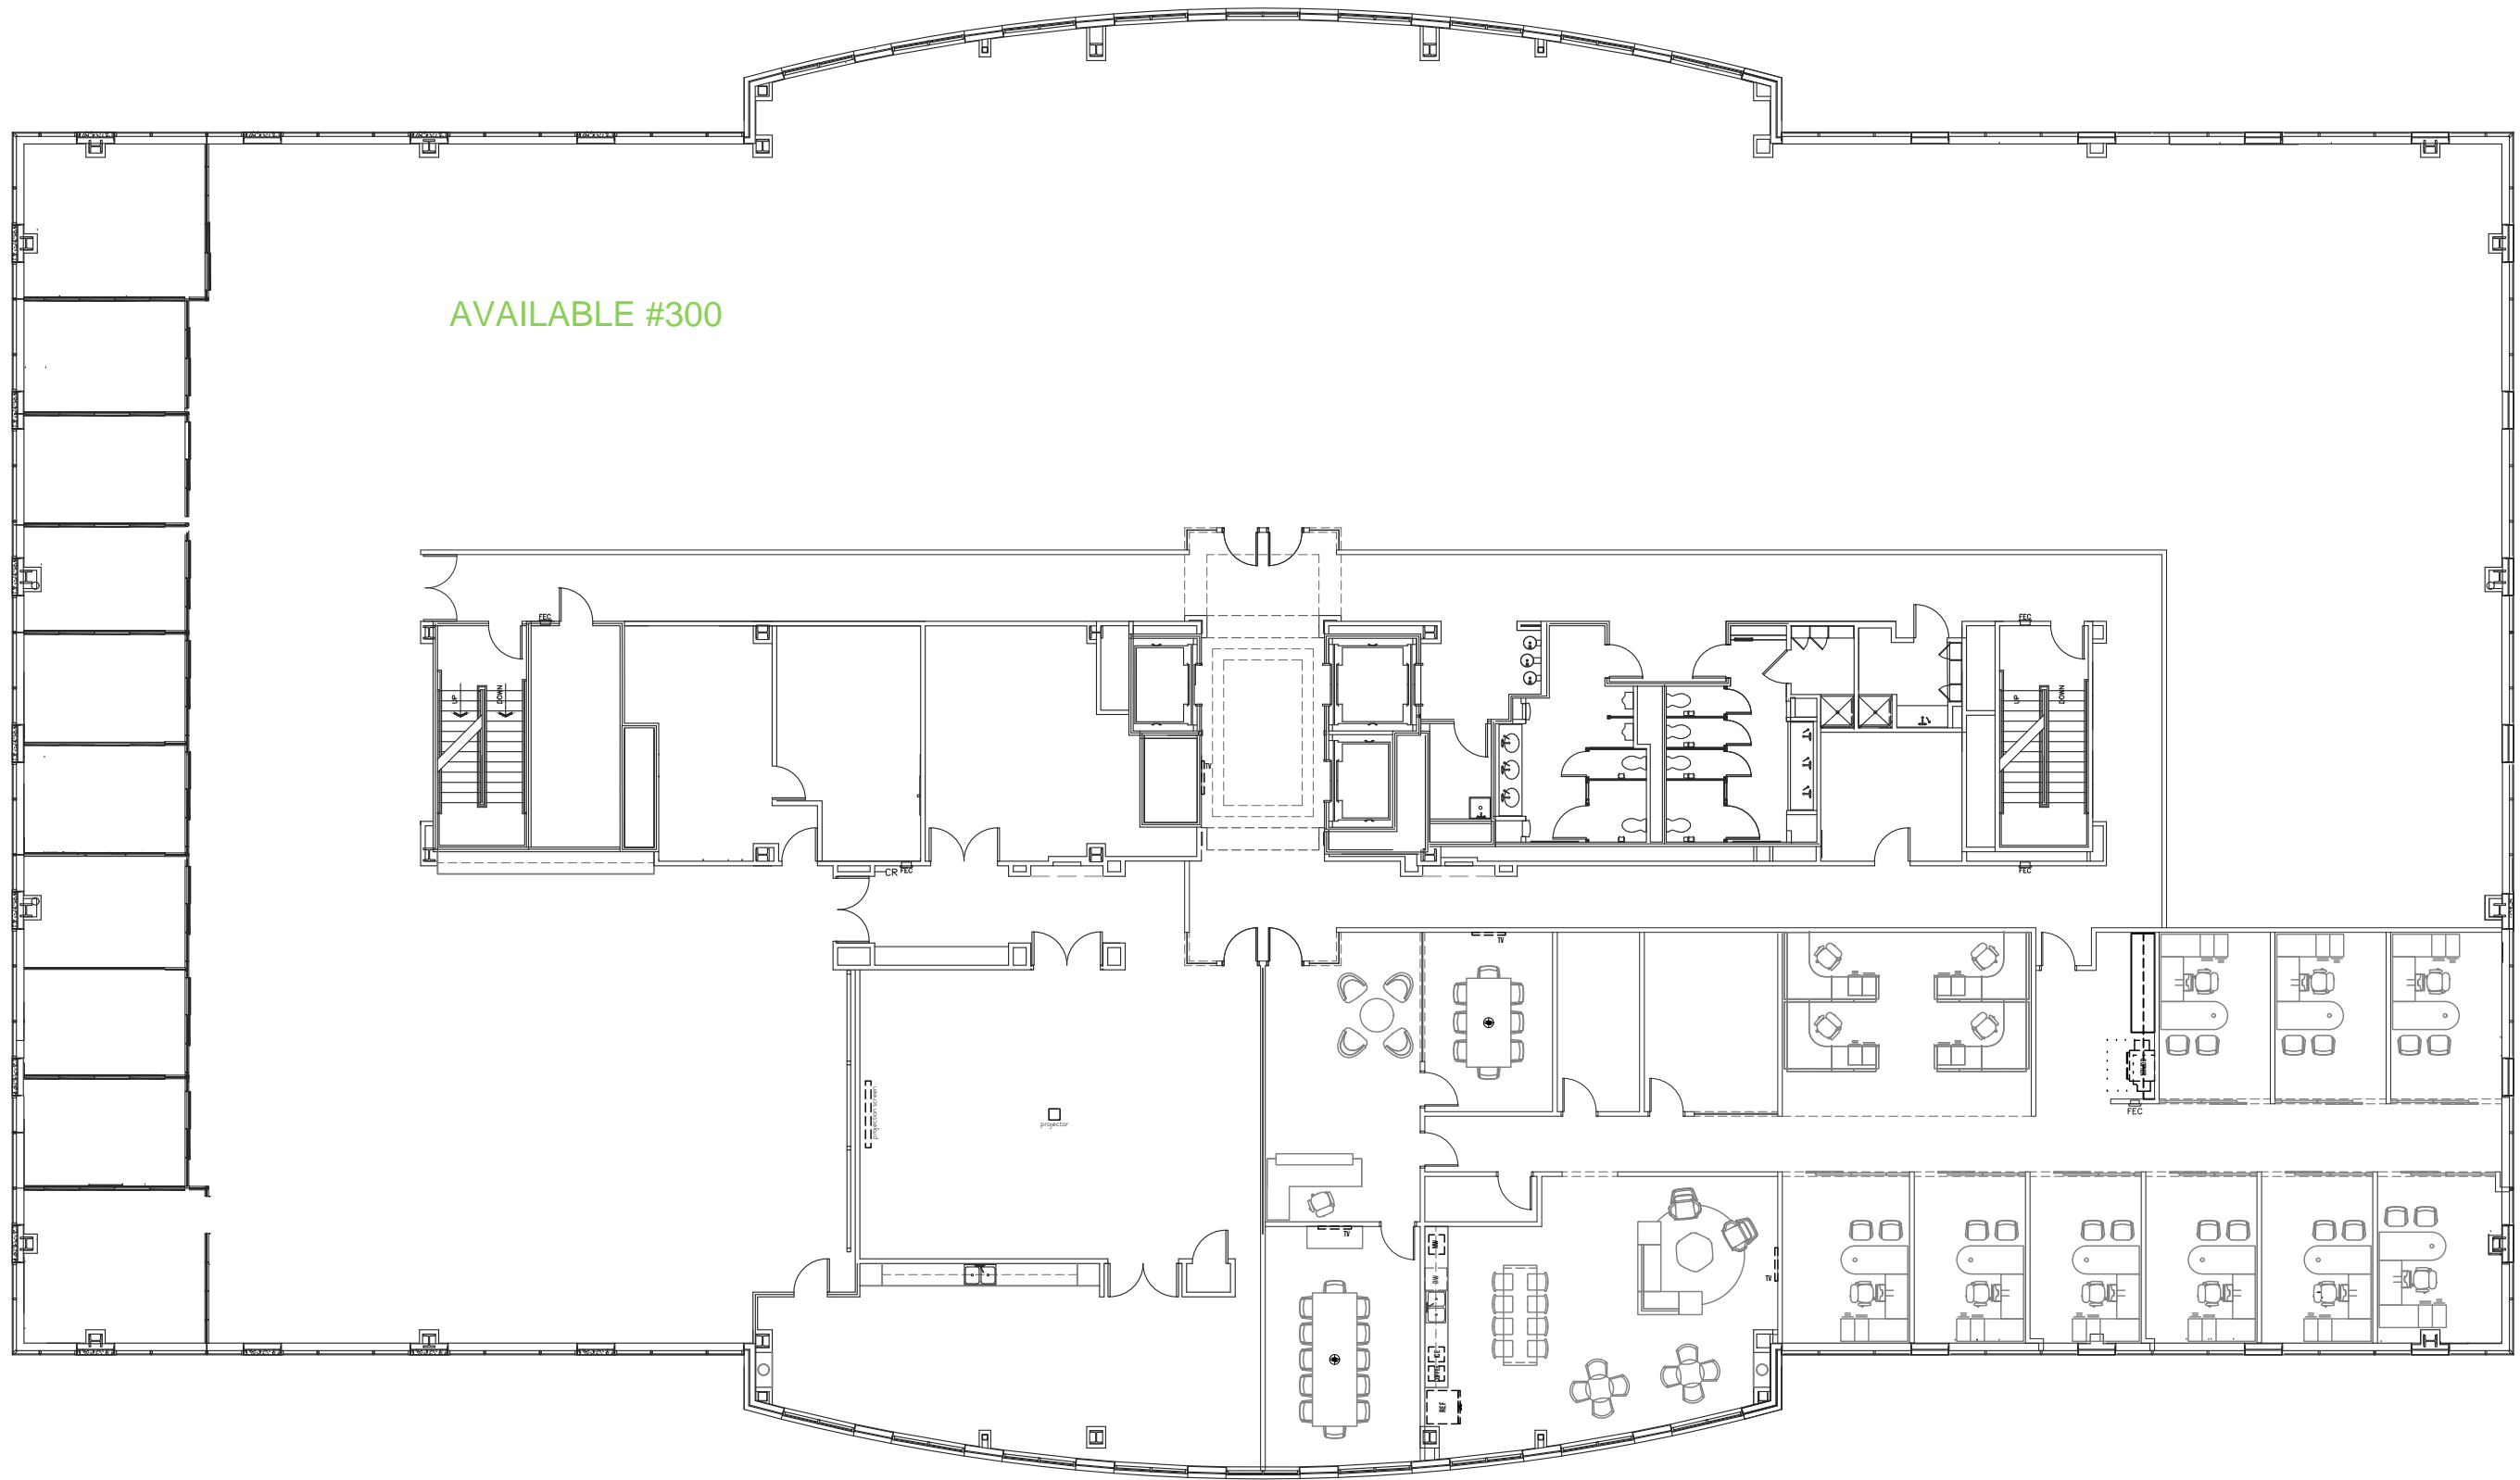

ELEVATE
DESIGN
©2016 ELEVATE DESIGN, LLC. ALL RIGHTS RESERVED.

3000 Meridian

3RD FLOOR AS-BUILT

ISSUE DATE: 12.10.2024

SCALE: 1/16"=1'-0"

